


S1, S2

~~D3 ah~~
~~D4 ah~~
~~D2 ch~~
~~D1 bh~~
~~D2 ch~~
~~D1 ah *~~

~~D1 bh~~
~~D2 ah~~ D 2 ch
~~D2 bh~~
~~D3 ah~~
~~D2 ch~~
~~D2 db (v)~~ BRED
~~D2 bh~~
~~D4 ah~~

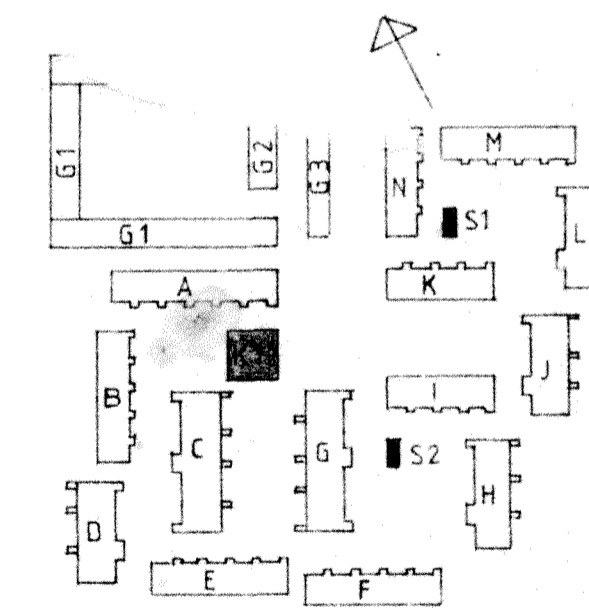

RIKSBYGGEN
 PROJEKTERINGSKONTORET I MALMÖ
 STADIONGATAN 10 TEL 040-801 60
 BOX 8057 200 41 MALMÖ

white
 White arkitekter AB • Malmö
 Västergatan 23 • 211 21 Malmö • Tel 040-776 90

RAMULÖSGÅRDE
 S ERIKSSON A REVELLE
 MALMÖ 21-02-20

A 2	U-centr. skorsten	HS	82-08-06
REG. ANT.	REGISTRERINGEN AVSER	SIGN.	DATUM
KÄVLINGE BOGESHOLMSOMRÅDET KÄVLINGE 7		KVARTERSHUS K1, SOPRUM S1, S2	
PLAMER		SKALA 1:50	
REG. TYP 1:75	RITNINGSH.	REG.	
77 00 40	A4:38	A	